


Plot Plan

Bearings are based on the Northerly boundary of Lot 1, Block 1, SUN CITY CENTER UNIT 274 - 275, said line bears S.84°39'43"W., per plat.
SCALE: 1" = 20'

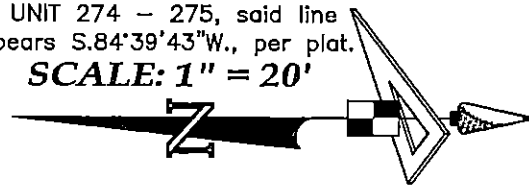

BUILDING LAYOUT NOTE:

Contractor and owner are to verify all setbacks, building dimensions, and layout shown hereon prior to any construction, and immediately advise GeoPoint Surveying, Inc. of any deviation from information shown hereon. Failure to do so will be at user's sole risk.

These plans are not reviewed for zoning conditions, contractor shall be responsible for all conditions noted.

Approval for new construction as indicated on this plan only; this does not constitute approval for any non-conformities or lot reconfigurations, past, present, or future.

SUN CITY CENTER UNIT 274 - 275
 PLAT BOOK 123, PAGES 82-93

NO Alteration to the existing grading and drainage pattern and no additional fill beyond the limits of construction may occur unless shown in an approved lot grading plan.

DIMENSION NOTE:
 Proposed building dimensions shown hereon are of the exterior.

GENERAL NOTES:
 Residence Footprint = 2,359± Square Feet
 As per the plans furnished by the builder.

Setbacks: (Reported)
 20ft. from all edge of pavement
 15ft. minimum distance between buildings
 20ft. from front of unit to all boundaries
 15ft. from rear of unit to all boundaries
 7.5ft. from side of unit to all boundaries
 (5.0ft. from side of unit to all boundaries for single family homes)
 Max Building Height = 35'

CURVE DATA TABLE

NO.	RADIUS	DELTA	ARC	CHORD	BEARING
C15	425.00'	22°08'31"	164.24'	163.22'	S 11°04'16" E
C40	450.00'	6°13'49"	48.93'	48.91'	N 05°16'07" W
C41	450.00'	2°09'27"	16.94'	16.94'	N 01°04'29" W


SOD AND CONCRETE CALCS

Combined Total Lot Area in Square Feet ±	Total Sod Area in Square Feet ± (Includes right-of-way area between front property line and back of curb)	Total Conc. Area in Square Feet ± (Includes Sidewalks and Driveway ONLY)
8,583	5,576	422

SEE DRAINAGE PLAN FOR GRADING AND ELEVATIONS

Mechanical equipment may not project 3 feet or no more than 50% required side yard

*Inside 140
 RM
 4-21-2015*

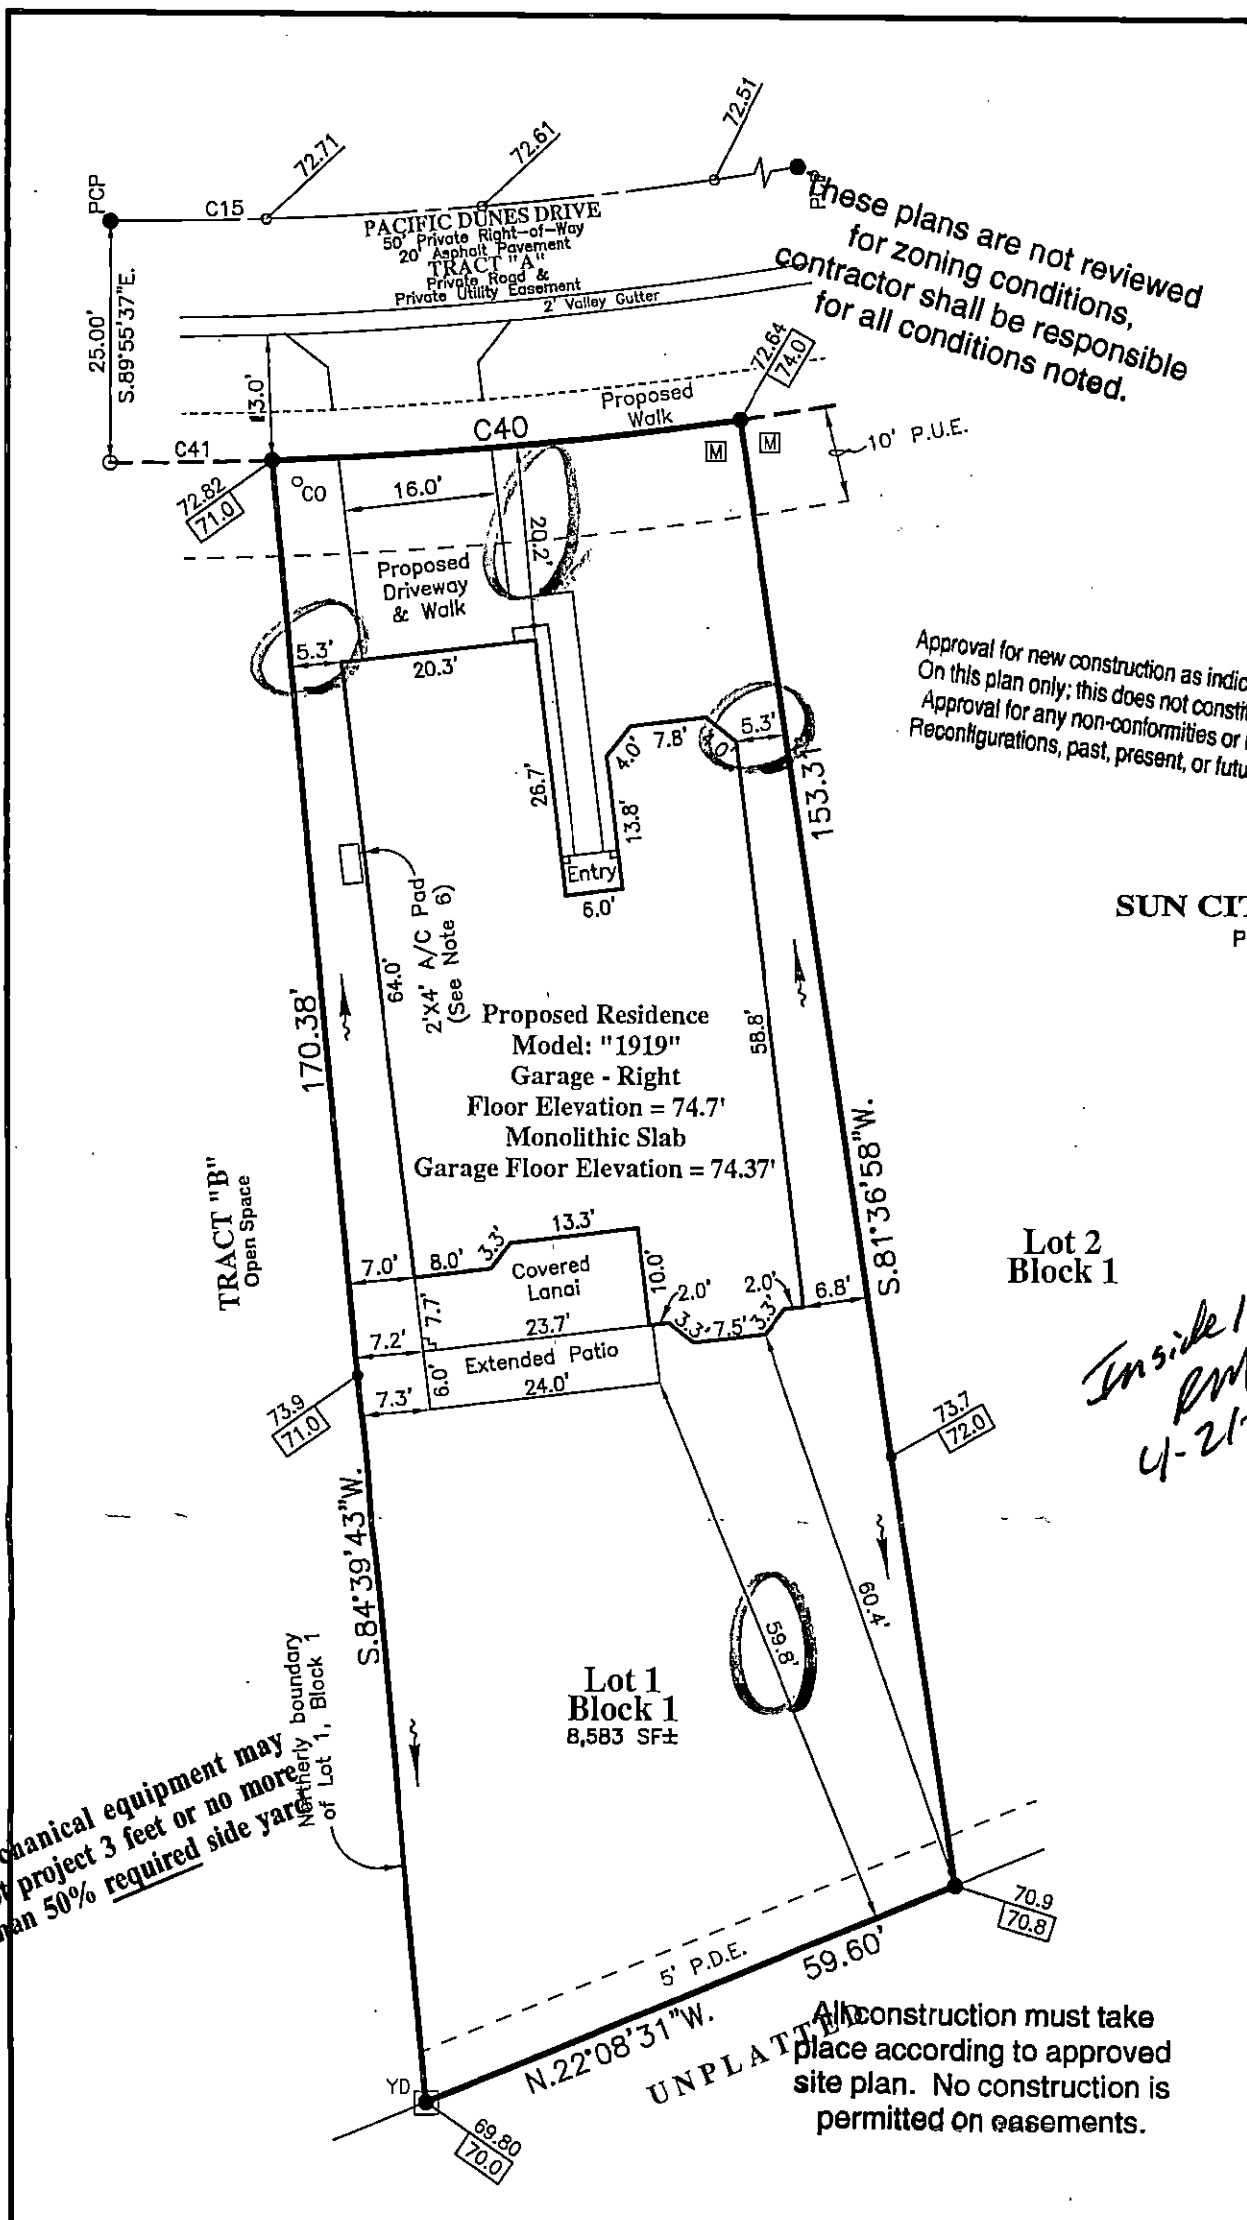

All construction must take place according to approved site plan. No construction is permitted on easements.

- LEGEND:**
- Pg. - Page
 - R/W - Right Of Way
 - O.R. - Official Records Book
 - P.B. - Plat Book
 - Elev. - Elevation
 - SF - Square Feet
 - Conc. - Concrete
 - BP - Brick Paver
 - SW - Sidewalk
 - CI - Curb Inlet
 - GTI - Grate Top Inlet
 - MES - Mitered End Section
 - RCP - Reinforced Conc. Pipe
 - PVC - Polyvinyl Chloride
 - P.K. - Parker Kalon Nail
 - SIR - Set 5/8" Iron Rod LB7768
 - SPKD - Set P.K. & Disk LB7768
 - FIR - Found 5/8" Iron Rod
 - LB148 (Unless Noted Otherwise)
 - FIP - Found 1/2" Iron Pipe
 - LB148 (Unless Noted Otherwise)
 - FPK - Found P.K. Nail
 - FPKD - Found P.K. Nail & Disk
 - FCM - Found Concrete Monument
 - REF - Reference
 - PRM - Permanent REF. Monument
 - PCP - Permanent Control Point
 - P.D.U.E. - Private Drainage Utility Easement
 - (Note: Some items in above legend may not be applicable)

- L.B. - Licensed Business
- ST - Stoop
- W - Water Meter
- WV - Water Valve
- FH - Fire Hydrant
- RCM - Reclaimed Water Meter
- RCV - Reclaimed Water Valve
- TEB - Telephone Box
- EB - Electric Box
- CTB - Cable Television Box
- LP - Light Pole
- SSM - Storm Sewer Manhole
- SSMH - Sanitary Sewer Manhole
- EH - Electric Handhole
- CO - Clean Out
- ICV - Irrigation Control Valve
- S - Sign
- A/C - Air Conditioner
- P.U.E. - Public Utility Easement
- P.D.E. - Private Drainage Easement
- O.E. - Drainage Easement
- L.M.E. - Lake Maintenance Easement
- YD - Yard Drain
- AE - Access Easement
- L.B.E. - Landscape Buffer Easement
- R.W.E. - Raw Water Well Easement
- OWS - Water Service
- DFD - Drainage Flow Direction
- 10.0 - Proposed Design Grade
- 10.2 - As-Built/Existing Grade

SURVEYOR'S NOTES:

- Current title information on the subject property had not been furnished to GeoPoint Surveying, Inc. at the time of this plot plan.
- Roads, walks, and other similar items shown hereon were taken from engineering plans and are subject to survey.
- Elevations shown hereon are in feet and are referenced to the National Geodetic Vertical Datum of 1929 (NGVD29).
- Proposed grades & finished floor elevations shown hereon are from the SUN CITY CENTER UNIT 274 - 275 Grading & Drainage Plan, provided by HEIDT DESIGN.
- This Plot Plan is subject to matters shown on the Plat of SUN CITY CENTER UNIT 274 - 275.
- Air Conditioning Unit is 2'x4', offset from building 0.5' and meets the Hillsborough County Easement Encroachment Requirement.

NOT A SURVEY (For Permitting ONLY)

WILLIAM E. LUOAS

FLORIDA PROFESSIONAL SURVEYOR & MAPPER NO. LS5782

PREPARED FOR:

MINTO COMMUNITIES, LLC

FLOOD ZONE:

The property shown hereon is on the Federal Emergency Management Agency's Flood Insurance Rate Map Panel Number 12057C0678H dated 08/28/08, and appears to lie in Zone "X".

DESCRIPTION: Lot 1, Block 1, SUN CITY CENTER UNIT 274 - 275, as recorded in Plat Book 123, Pages 82 through 93 inclusive, in the Public Records of Hillsborough County, Florida.

1403 E. 5th Avenue
 Tampa, Florida 33605
 Phone: (813) 248-8888
 Fax: (813) 248-2266
 Licensed Business No. LB7768



GeoPoint
 Surveying, Inc.

Drawn: SF	Checked: WEL	P.C.: ~	Data File: ~
Date: 04/07/15	Dwg: 1_Block 1_PP.dwg	Order No.: MIN-SC-184	Field Bk: ~
SEC. 18 - TWN. 32 S. - RNG. 20 E.			

REVISIONS

Description	Date	Dwn.	Ck'd	P.C.	Order No.	Field Book