

**GENERAL NOTES:**

Residence Footprint = 2,560± Square Feet  
As per the plans furnished by the builder.


Setbacks: (Reported)  
20ft. from all edge of pavement  
15ft. minimum distance between buildings  
20ft. from front of unit to all boundaries  
15ft. from rear of unit to all boundaries  
7.5ft. from side of unit to all boundaries  
(5.0ft. from side of unit to all boundaries for single family homes)  
Mox Building Height = 35'

Vertical Conversion Note: conformities or lot  
Conversion from National Geodetic Vertical Datum  
of 1929 (NGVD29) to North American Vertical  
Datum of 1988, (NAVD88) is 0.92 feet.  
(NGVD82 = NAVD88)

PCP - Permanent Control Point  
No monument found or recovered  
at time of survey and that the  
PCP location shown hereon is for  
informational purposes only, unless  
otherwise noted.

# Plot Plan


SUN CITY CENTER UNIT 274 - 275  
PLAT BOOK 123, PAGES 82-93

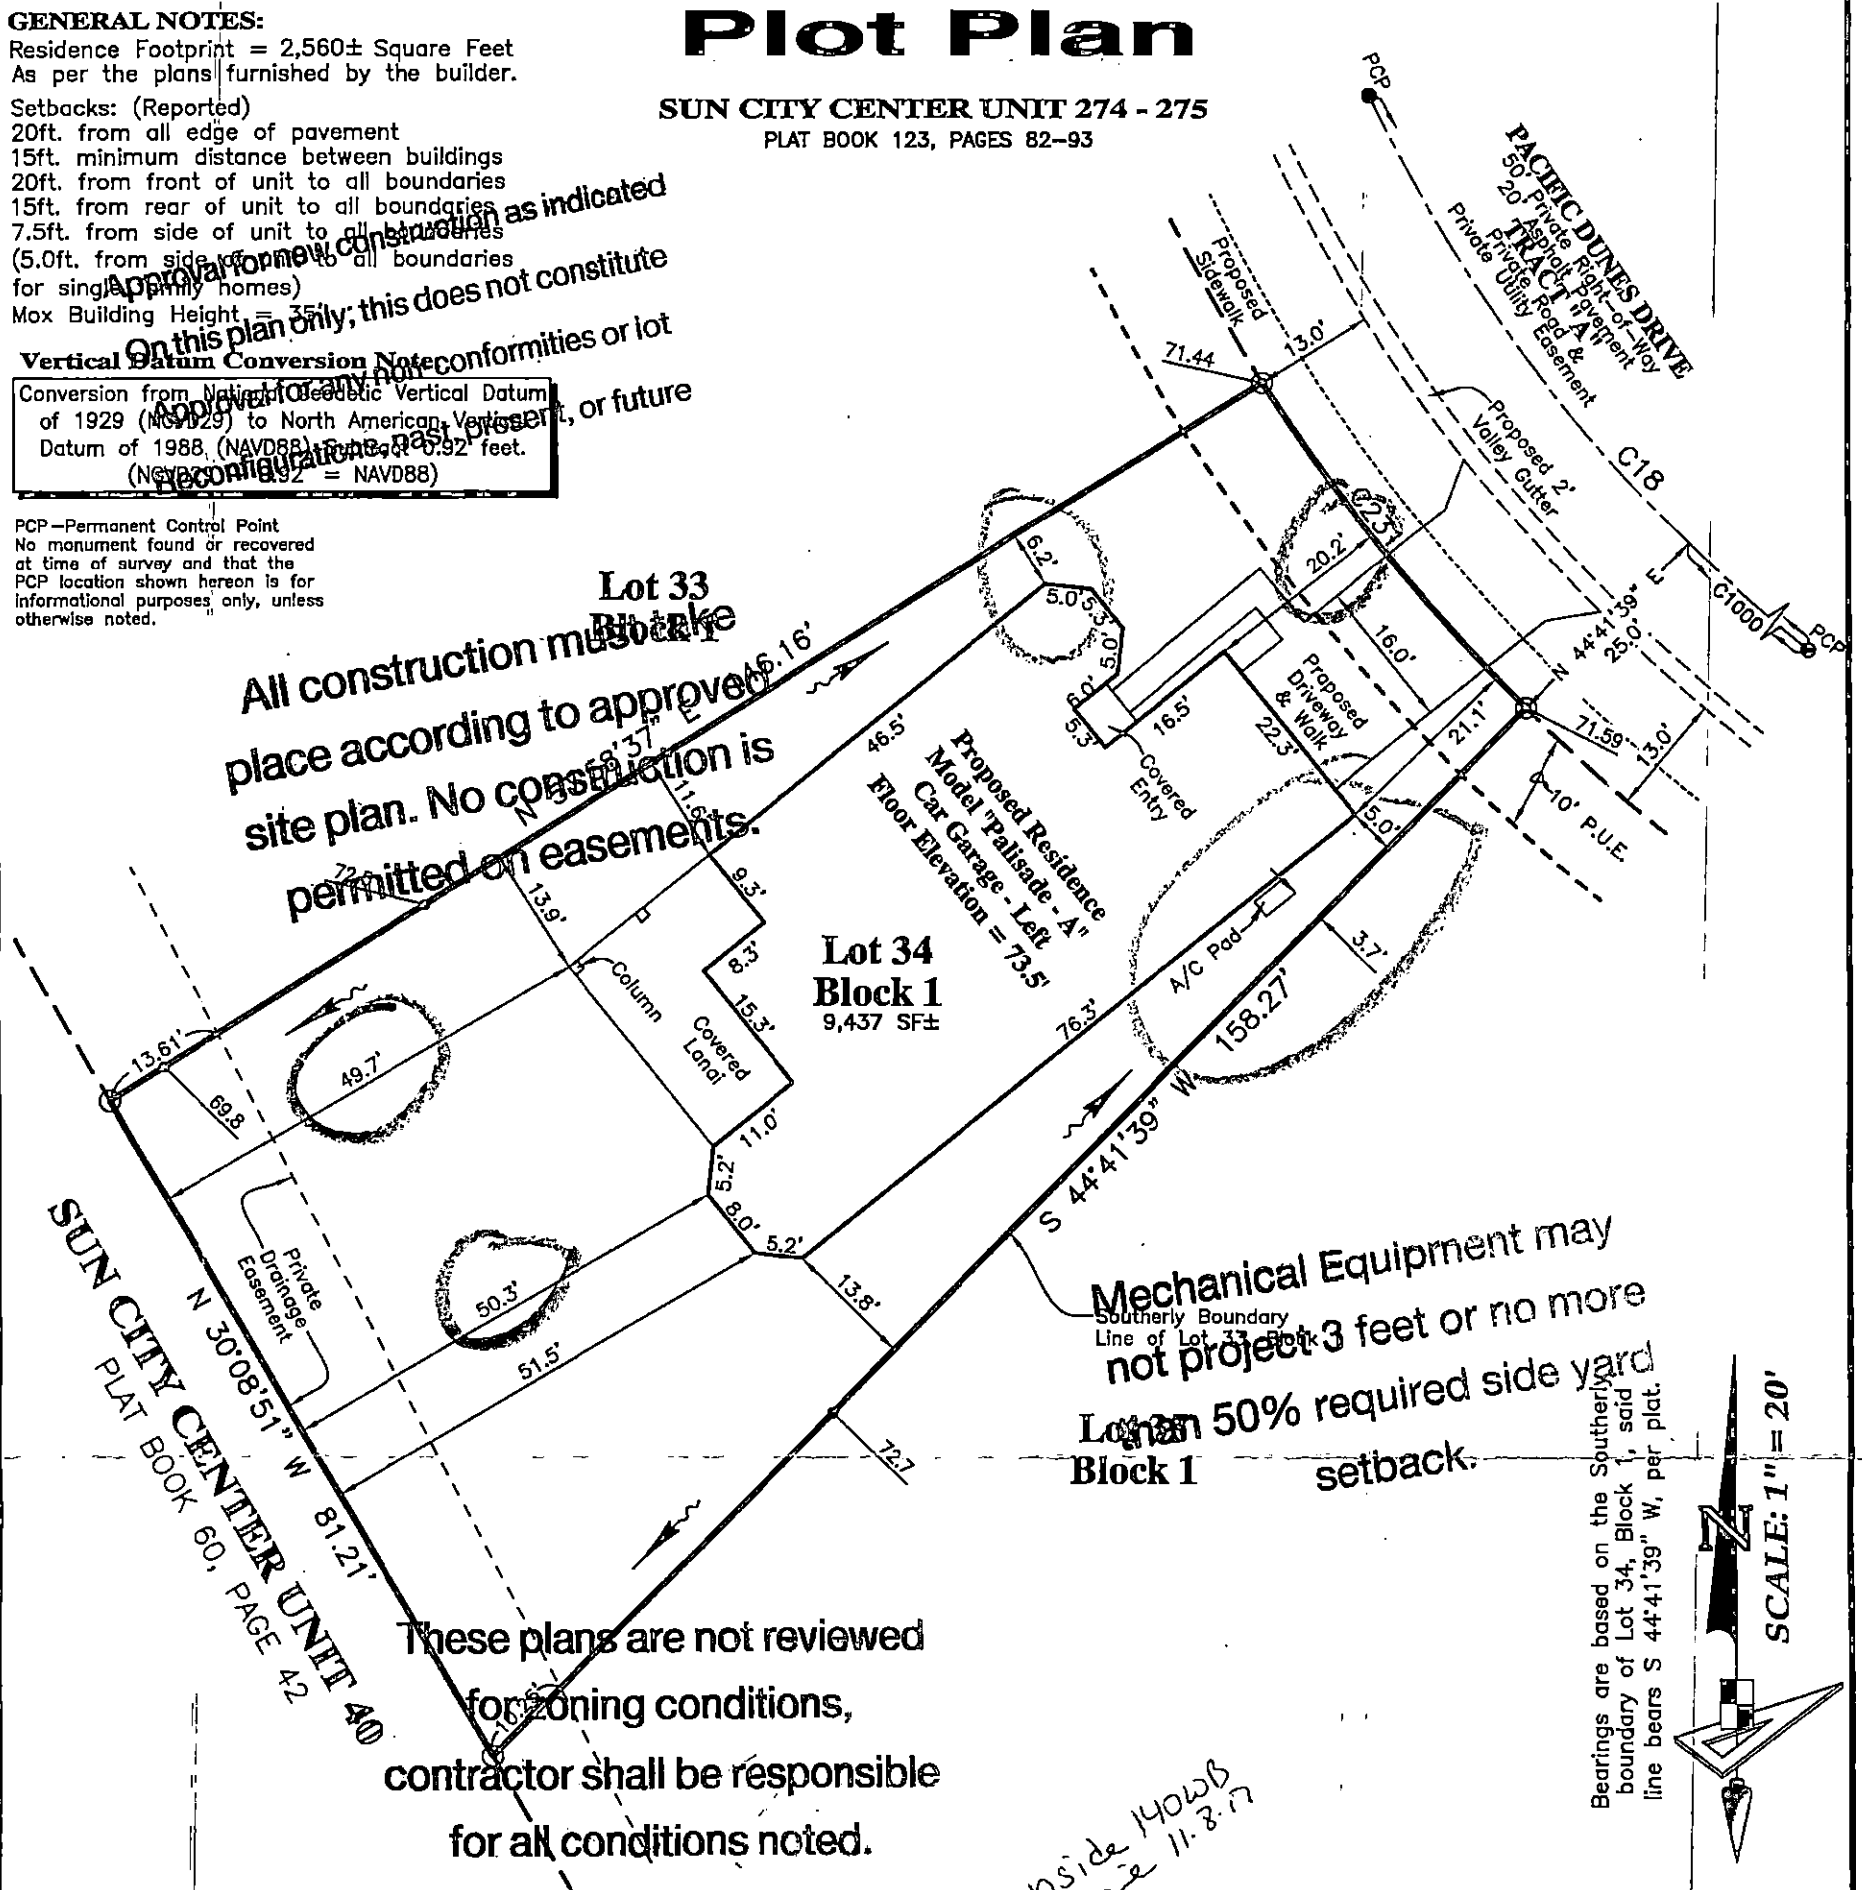

All construction must take place according to approved site plan. No construction is permitted on easements.

Mechanical Equipment may not project 3 feet or no more than 50% required side yard setback.

These plans are not reviewed for zoning conditions, contractor shall be responsible for all conditions noted.

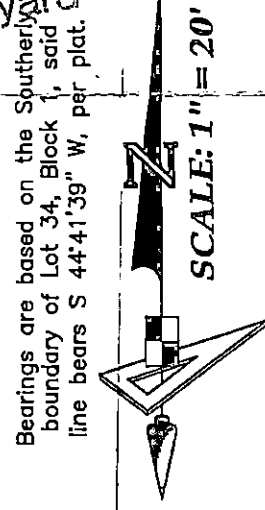

CURVE DATA TABLE

NO.	RADIUS	DELTA	ARC	CHORD	BEARING
C231	195.00'	13°16'58"	45.21'	45.11'	S 38°39'52" E
C18	170.00'	112°09'12"	332.77'	282.13'	S 12°04'15" E
C1000	170.00'	22°50'30"	67.77'	67.32'	S 56°43'36" E

**AREA (For Quantity Takeoff): : Lot 33 Block 1**

- Brick Pavers (Driveway & Walk) = 625 SF±
- Concrete Sidewalk (in Right Of Way) = 223 SF±
- Sod (Includes Lot To Back of Curb) = 6,263 SF±

**BUILDING LAYOUT NOTE:**

Contractor and owner are to verify all setbacks, building dimensions, and layout shown hereon prior to any construction, and immediately advise GeoPoint Surveying, Inc. of any deviation from information shown hereon. Failure to do so will be at user's sole risk.

**SURVEYOR'S NOTES:**

1. Current information on the subject property had not been furnished to GeoPoint Surveying, Inc. at the time of this plot plan.
2. Roads, walks, and other similar items shown hereon were taken from engineering plans and are subject to survey.
3. Elevations shown hereon are in feet and are referenced to the National Geodetic Vertical Datum of 1929 (NGVD29).
4. Proposed grades & finished floor elevations shown hereon are from the SUN CITY CENTER UNIT 274 - 275 Grading & Drainage Plan, provided by HEIDT DESIGN.
5. This Plot Plan is subject to matters shown on the Plat of SUN CITY CENTER UNIT 274 - 275.
6. Air Conditioning Unit is 2'x4', offset from building 0.5' and meets the Hillsborough County Easement Encroachment Requirement.

**PREPARED FOR:**

MINTO COMMUNITIES, LLC

**FLOOD ZONE:**  
The property shown hereon is on the Federal Emergency Management Agency's Flood Insurance Rate Map Panel Number 12057C0678H dated 08/28/08, and appears to lie in Zone X.

**DESCRIPTION:** Lot 34, Block 1, SUN CITY CENTER UNIT 274 - 275, as recorded in Plat Book 123, Pages 82 through 93 inclusive, in the Public Records of Hillsborough County, Florida.

1403 E. 5th Avenue  
Tampa, Florida 33605  
Phone: (813) 248-8888  
Fax: (813) 248-2266  
Licensed Business No. LB7768



**LEGEND:**

Pg. - Page	LB - Licensed Business
R/W - Right Of Way	ST - Stoop
O.R. - Official Records Book	W - Water Valve
P.B. - Plat Book	WV - Water Valve
Elev. - Elevation	YH - Fire Hydrant
SF - Square Feet	ACM - Reclaimed Water Valve
Conc. - Concrete	WV - Reclaimed Water Valve
BP - Brick Paver	TE - Telephone Box
SW - Sidewalk	EB - Electric Box
CI - Curb Inlet	CT - Cable Television Box
GI - Grate Top Inlet	LP - Light Pole
MES - Mitered End Section	SM - Storm Sewer Manhole
RCP - Reinforced Conc. Pipe	SSM - Sanitary Sewer Manhole
PVC - Polyvinyl Chloride	EH - Electric Handhole
P.K. - Parker Kalon Nail	CO - Clean Out
SIR - Set 5/8" Iron Rod LB7768	ICV - Irrigation Control Valve
SPKD - Set P.K. & Disk LB7768	S - Sign
FIR - Found 5/8" Iron Rod	AC - Air Conditioner
LB148 (Unless Noted Otherwise)	P.U.E. - Public Utility Easement
FIP - Found 1/2" Iron Pipe	P.D.E. - Private Drainage Easement
LB148 (Unless Noted Otherwise)	D.E. - Drainage Easement
FPK - Found P.K. Nail	L.M.E. - Lake Maintenance Easement
FPKD - Found P.K. Nail & Disk	YD - Yard Drain
FCM - Found Concrete Monument	AE - Access Easement
REF - Reference	LB.E. - Landscape Buffer Easement
PRM - Permanent REF. Monument	R.W.E. - Raw Water Well Easement
PCP - Permanent Control Point	W.S. - Water Service
P.D.U.E. - Private Drainage Utility Easement	DWS - Drainage Flow Direction
(Note: Some items in above legend may not be applicable)	10.0 - Proposed Design Grade
	10.2 - As-Built/Existing Grade

**REVISIONS**

Description	Date	Dwn.	Ck'd	P.C.	Order No.	Field Book

**NOT A SURVEY (For Permitting ONLY)**

EDWARD W. WACKERMAN  
License Number 3696

EDWARD W. WACKERMAN  
FLORIDA PROFESSIONAL SURVEYOR & MAPPER NO. PLS3696

Drawn: LWJ	Checked: EWW	P.C.: ~	Data File: ~
Date: 10/18/17	Dwg: 34_Block 1_PP.dwg	Order No.: ~	Field Bk: ~
SEC. 18 - TWN. 32 S. - RNG. 20 E.			