

GENERAL NOTES:

Residence Footprint = 2,908± Square Feet
 As per the plans furnished by the builder.

Setbacks: (Reported)
 20ft. from all edge of pavement
 15ft. minimum distance between buildings
 20ft. from front of unit to all boundaries
 15ft. from rear of unit to all boundaries
 7.5ft. from side of unit to all boundaries
 (5.0ft. from side of unit to all boundaries for single family homes)

Max Building Height = 35'

DIMENSION NOTE:


Proposed building dimensions shown hereon are of the exterior.

Plot Plan

SUN CITY CENTER UNIT 274 - 275


PLAT BOOK 123, PAGES 82-93

Bearings are based on the Northerly boundary of Lot 51, Block 1, said line bears S 72°46'03" E, per plat.

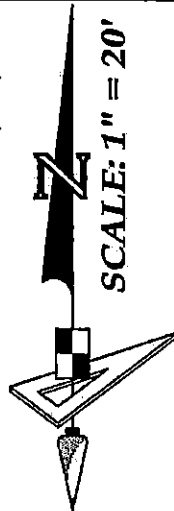

Placement of mechanical equipment must comply with HC LDC 6.01.03.I.3. Mechanical equipment may not project into the front yard(s) but may project five feet into the required rear yard(s) and three feet or no more than 50 percent of the required side yard(s), whichever is more restrictive.

PCP—Permanent Control Point
 No monument found or recovered at time of survey and that the PCP location shown hereon is for informational purposes only, unless otherwise noted.

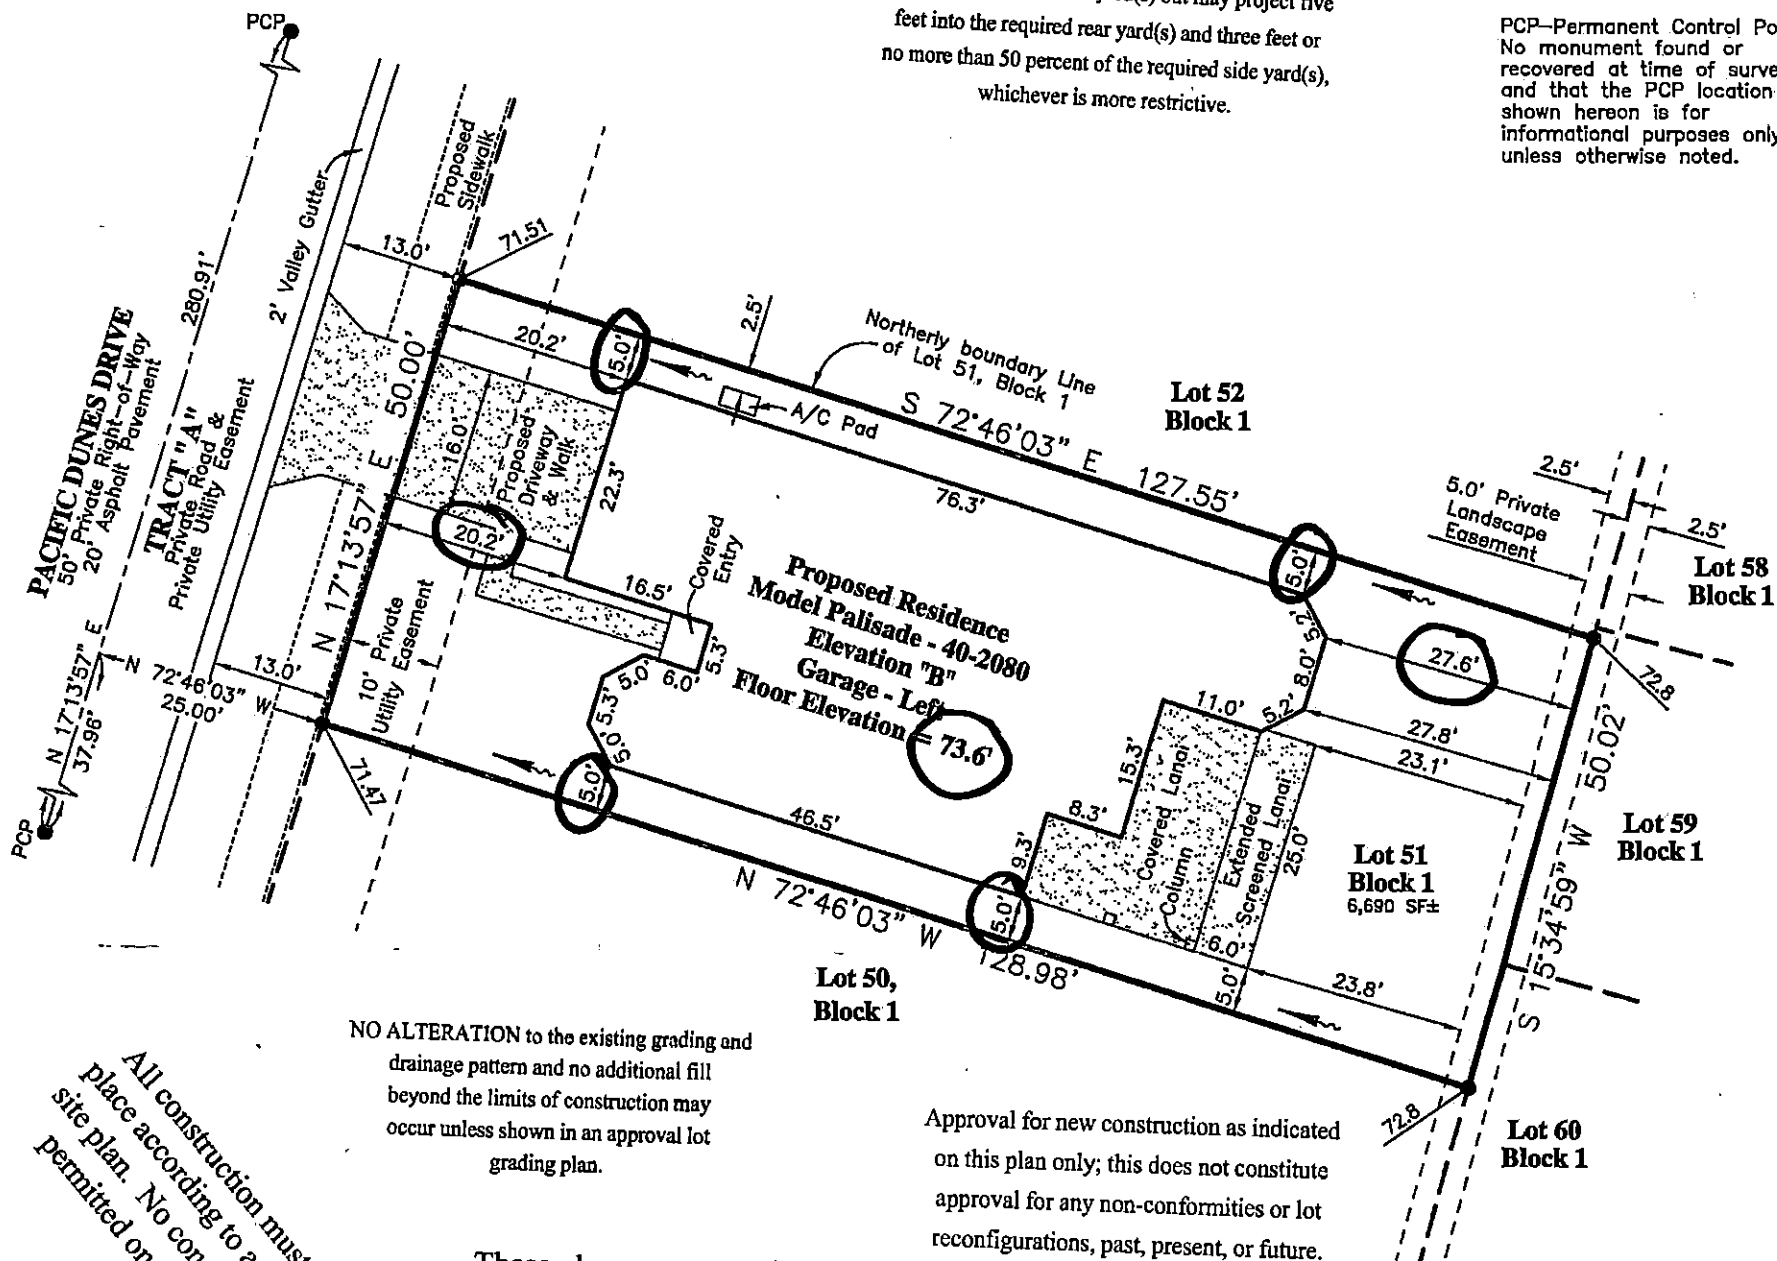

All construction must take place according to approved site plan. No construction is permitted on easements.

NO ALTERATION to the existing grading and drainage pattern and no additional fill beyond the limits of construction may occur unless shown in an approval lot grading plan.

Approval for new construction as indicated on this plan only; this does not constitute approval for any non-conformities or lot reconfigurations, past, present, or future.

These plans are not reviewed for zoning conditions, contractor shall be responsible for all conditions noted.

7-13-18
RT

AREA (For Quantity Takeoff): Lot 51 Block 1

Brick Pavers (Driveway & Walk)	= 621 SF±
Concrete Sidewalk (In Right Of Way)	= 170 SF±
Sod (Includes Lot To Back of Curb)	= 3,189 SF±

Vertical Datum Conversion Note:

Conversion from National Geodetic Vertical Datum of 1929 (NGVD29) to North American Vertical Datum of 1988 (NAVD88) Subtract 0.92 feet. (NGVD29 - 0.92' = NAVD88)

BUILDING LAYOUT NOTE:

Contractor and owner are to verify all setbacks, building dimensions, and layout shown hereon prior to any construction, and immediately advise GeoPoint Surveying, Inc. of any deviation from information shown hereon. Failure to do so will be at user's sole risk.

LEGEND:

Pg.—Page	R/W—Right Of Way	O.R.—Official Records Book	P.B.—Plat Book	Elev.—Elevation	SF—Square Feet	Conc.—Concrete	BP—Brick Paver	SW—Sidewalk	CI—Curb Inlet	GTI—Grate Top Inlet	MES—Mitered End Section	RCP—Reinforced Conc. Pipe	PVC—Polyvinyl Chloride	P.K.—Parker Kalon Nail	SIR—Set 5/8" Iron Rod LB7768	SPKD—Set P.K. & Disk LB7768	FIR—Found 5/8" Iron Rod LB148 (Unless Noted Otherwise)	FIP—Found 1/2" Iron Pipe LB148 (Unless Noted Otherwise)	FPK—Found P.K. Nail	FPKD—Found P.K. Nail & Disk	FCM—Found Concrete Monument	REF—Reference	PRM—Permanent REF. Monument	PCP—Permanent Control Point	P.D.U.E.—Private Drainage Utility Easement	

(Note: Some items in above legend may not be applicable)

SURVEYOR'S NOTES:

- Current title information on the subject property had not been furnished to GeoPoint Surveying, Inc. at the time of this plot plan.
- Roads, walks, and other similar items shown hereon were taken from engineering plans and are subject to survey.
- Elevations shown hereon are in feet and are referenced to the National Geodetic Vertical Datum of 1929 (NGVD29).
- Proposed grades & finished floor elevations shown hereon are from the SUN CITY CENTER UNIT 274 - 275 Grading & Drainage Plan, provided by HEIDT DESIGN.
- This Plot Plan is subject to matters shown on the Plot of SUN CITY CENTER UNIT 274 - 275.
- Air Conditioning Unit is 2'x4', offset from building 0.5' and meets the Hillsborough County Easement Encroachment Requirement.

PREPARED FOR:
MINTO COMMUNITIES, LLC

FLOOD ZONE:
 The property shown hereon is on the Federal Emergency Management Agency's Flood Insurance Rate Map Panel Number 12057C067BH dated 08/28/08, and appears to lie in Zone "X".

DESCRIPTION: Lot 51, Block 1, SUN CITY CENTER UNIT 274 - 275, as recorded in Plat Book 123, Pages 82 through 93 inclusive, in the Public Records of Hillsborough County, Florida.

213 Hobbs Street
 Tampa, Florida 33619
 Phone: (813) 248-8888
 Fax: (813) 248-2266
 Licensed Business No. LB7768

REVISIONS

Description	Date	Dwn.	Ck'd	P.C.	Order No.	Field Book

NOT A SURVEY (For Permitting ONLY)

EDWARD W. WACKERMAN
 FLORIDA PROFESSIONAL SURVEYOR & MAPPER NO. PLS3696

Drawn: LWJ	Checked: EWW	P.C.: ~	Data File: ~
Date: 6/01/18	Dwg: 51_Block 1_PP.dwg	Order No.: ~	Field Bk: ~
SEC. 18 - TWN. 32 S. - RNG. 20 E.			