


Plot Plan

DIMENSION NOTE:
Proposed building dimensions shown hereon are of the exterior.

SUN CITY CENTER UNIT 274 - 275
PLAT BOOK 123, PAGES 82-93

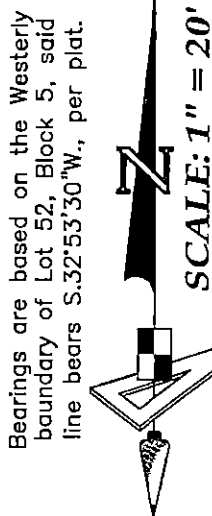

All construction must take place according to approved site plan. No construction is permitted without easements.


Combined Area of Lot in Square Feet ±	Lot Area in Square Feet ±	Total Conc. Area in Square Feet ± (Includes Sidewalks and Driveway ONLY)
17,087	12,020	1,500

SEE DRAINAGE PLAN FOR GRADING AND ELEVATIONS

GENERAL NOTES:
Residence Footprint = 4,261± Square Feet
As per the plans furnished by the builder.
Setbacks: (Reported)
20ft. from all edge of pavement
15ft. minimum distance between buildings
20ft. from front of unit to all boundaries
15ft. from rear of unit to all boundaries
7.5ft. from side of unit to all boundaries
(5.0ft. from side of unit to all boundaries for single family homes)
Max Building Height = 35'

BUILDING LAYOUT NOTE:
Contractor and owner are to verify all setbacks, building dimensions, and layout shown hereon prior to any construction, and immediately advise GeoPoint Surveying, Inc. of any deviation from information shown hereon. Failure to do so will be at user's sole risk.

Mechanical Equipment may not project 3 feet or no more than 50% required side yard setback.

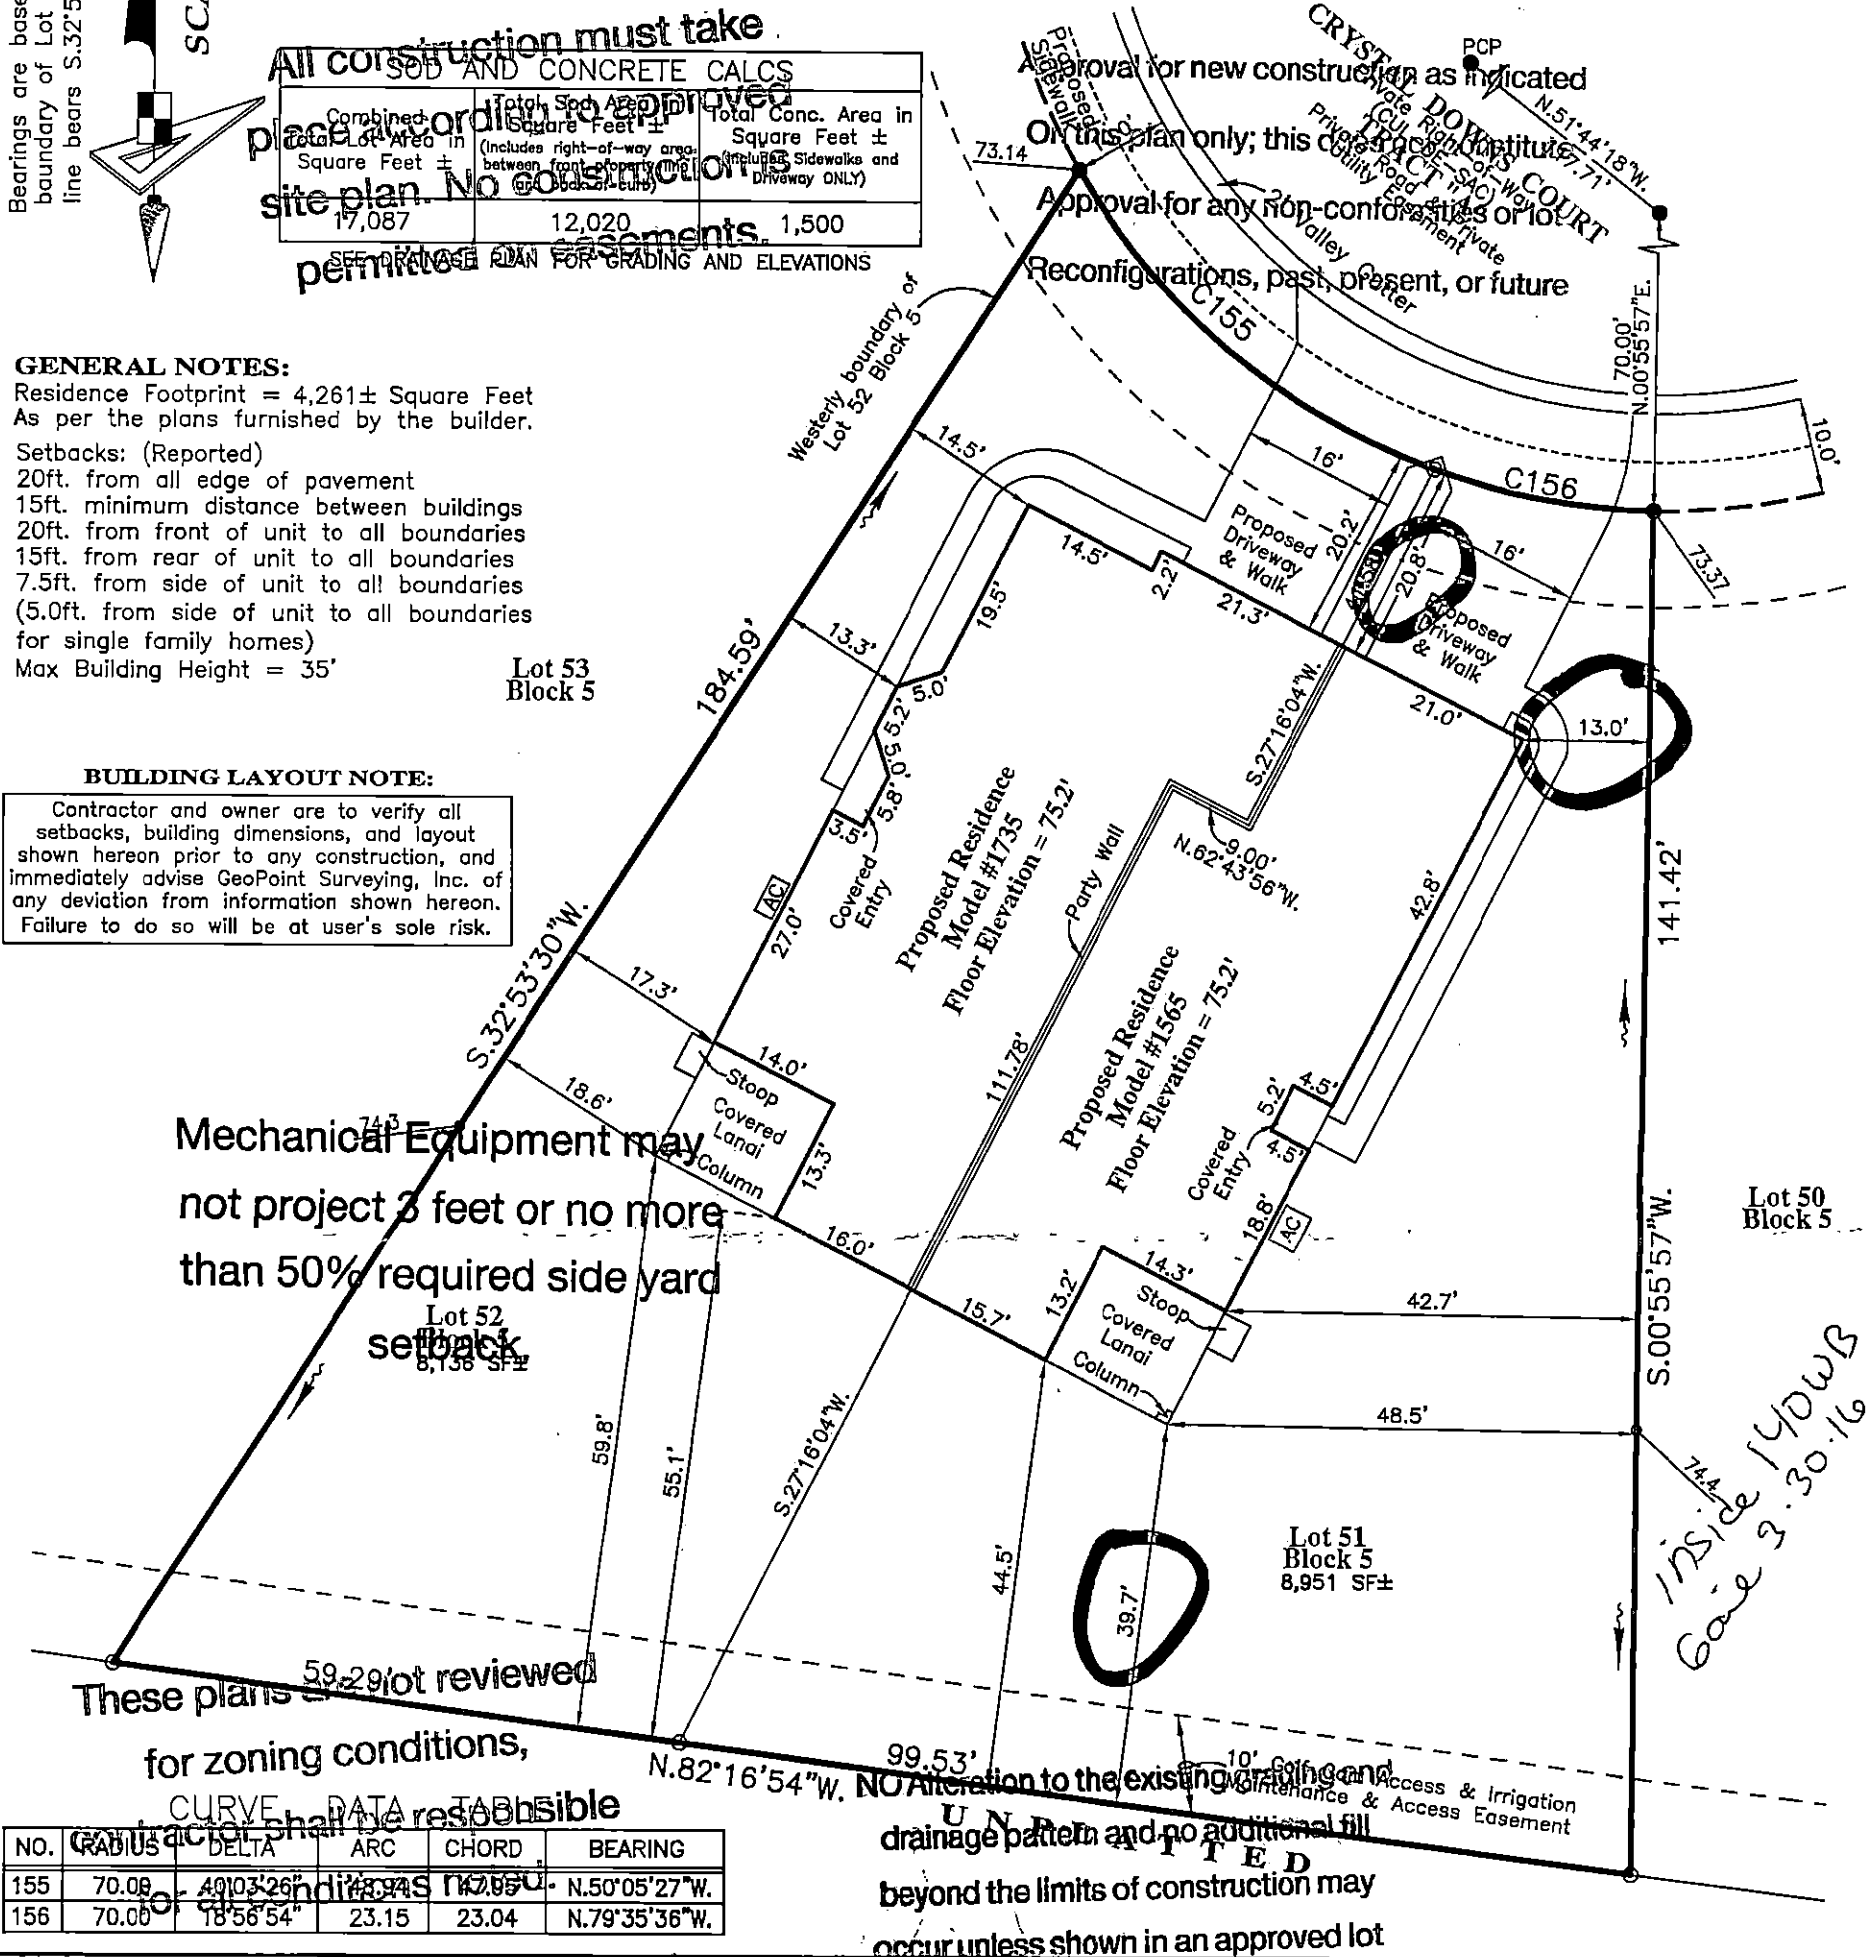

CURVE DATA TABLE

NO.	RADIUS	DELTA	ARC	CHORD	BEARING
155	70.00	40°03'26"	23.94	23.09	N.50°05'27"W.
156	70.00	18°56'54"	23.15	23.04	N.79°35'36"W.

LEGEND:

Pg.—Page	R/W—Right Of Way	O.R.—Official Records Book	P.B.—Plat Book	Elev.—Elevation	SF—Square Feet	Conc.—Concrete	BP—Brick Paver	SW—Sidewalk	CI—Curb Inlet	GTI—Grate Top Inlet	MES—Mitered End Section	RCP—Reinforced Conc. Pipe	PVC—Polyvinyl Chloride	P.K.—Parker Kalon Nail	SIR—Set 5/8" Iron Rod LB7768	SPKD—Set P.K. & Disk LB7768	FIR—Found 5/8" Iron Rod LB148 (Unless Noted Otherwise)	FIP—Found 1/2" Iron Pipe LB148 (Unless Noted Otherwise)	FPK—Found P.K. Nail	FPKD—Found P.K. Nail & Disk	FCM—Found Concrete Monument	REF—Reference	PRM—Permanent REF. Monument	PCP—Permanent Control Point	P.D.U.E.—Private Drainage Utility Easement	LB.—Licensed Business	ST—Stoop	W—Water Meter	WM—Water Valve	F—Fire Hydrant	RCM—Reclaimed Water Meter	RCV—Reclaimed Water Valve	T—Telephone Box	E—Electric Box	CTB—Cable Television Box	L—Light Pole	SM—Storm Sewer Manhole	SSM—Sanitary Sewer Manhole	EH—Electric Handhole	CO—Clean Out	ICV—Irrigation Control Valve	S—Sign	AC—Air Conditioner	P.U.E.—Public Utility Easement	P.D.E.—Private Drainage Easement	D.E.—Drainage Easement	L.M.E.—Lake Maintenance Easement	YD—Yard Drain	A.E.—Access Easement	L.B.E.—Landscape Buffer Easement	R.W.E.—Raw Water Well Easement	W.S.—Water Service	D.F.—Drainage Flow Direction	P.D.—Proposed Design Grade	A.B.—As-Built/Existing Grade
----------	------------------	----------------------------	----------------	-----------------	----------------	----------------	----------------	-------------	---------------	---------------------	-------------------------	---------------------------	------------------------	------------------------	------------------------------	-----------------------------	--	---	---------------------	-----------------------------	-----------------------------	---------------	-----------------------------	-----------------------------	--	-----------------------	----------	---------------	----------------	----------------	---------------------------	---------------------------	-----------------	----------------	--------------------------	--------------	------------------------	----------------------------	----------------------	--------------	------------------------------	--------	--------------------	--------------------------------	----------------------------------	------------------------	----------------------------------	---------------	----------------------	----------------------------------	--------------------------------	--------------------	------------------------------	----------------------------	------------------------------

SURVEYOR'S NOTES:

- Current title information on the subject property had not been furnished to GeoPoint Surveying, Inc. at the time of this plot plan.
- Roads, walks, and other similar items shown hereon were taken from engineering plans and are subject to survey.
- Elevations shown hereon are in feet and are referenced to the National Geodetic Vertical Datum of 1929 (NGVD29).
- Proposed grades & finished floor elevations shown hereon are from the SUN CITY CENTER UNIT 274 - 275 Grading & Drainage Plan, provided by HEIDT DESIGN.
- This Plot Plan is subject to matters shown on the Plat of SUN CITY CENTER UNIT 274 - 275.
- Air Conditioning Unit is 2'x4', offset from building D.5' and meets the Hillsborough County Easement Encroachment Requirement.

PREPARED FOR:
MINTO COMMUNITIES, LLC

FLOOD ZONE:
The property shown hereon is on the Federal Emergency Management Agency's Flood Insurance Rate Map Panel Number 12057C0678H dated 08/28/08, and appears to lie in Zone "X".

DESCRIPTION: Lots 51 & 52, Block 5, SUN CITY CENTER UNIT 274 - 275, as recorded in Plat Book 123, Pages 82 through 93 inclusive, in the Public Records of Hillsborough County, Florida.

1403 E. 5th Avenue
Tampa, Florida 33605
Phone: (813) 248-8888
Fax: (813) 248-2266
Licensed Business No. LB7768

GeoPoint Surveying, Inc.

Drawn: DJW	Checked: EVH	P.C.: ~	Data File: ~
Date: 03/17/16	Dwg: 51&52_BLK5_PP.dwg	Order No.: ~	
SEC. 18 - TWN. 32 S. - RNG. 20 E.		Field Bk: ~	

NOT A SURVEY (For Permitting ONLY)

E. VERNON HORNE
FLORIDA PROFESSIONAL SURVEYOR & MAPPER NO. 155610