


Plot Plan

Bearings are based on the Eastern boundary of Lot 53, Block 5, said line bears S.32°53'30"W., per plat.

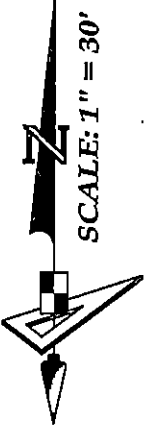

GENERAL NOTES:

Residence Footprint = 4,261± Square Feet
As per the plans furnished by the builder.

Setbacks: (Reported)
20ft. from all edge of pavement
15ft. minimum distance between buildings
20ft. from front of unit to all boundaries
15ft. from rear of unit to all boundaries
7.5ft. from side of unit to all boundaries
(5.0ft. from side of unit to all boundaries for single family homes)
Max Building Height = 35'

inside 140 Beck 720-16

SUN CITY CENTER UNIT 274 - 275


PLAT 123, PAGES 82-93

Placement of mechanical equipment must comply with HC LDC 6.01.03.1.3. Mechanical equipment may not project into the front yard(s) and three feet or feet into the required rear yard(s) and three feet or no more than 50 percent of the required side yard(s), whichever is more restrictive.

All construction must take place according to approved site plan. No construction is permitted on easements.

NO Alteration to the existing grading and drainage pattern, and NO additional fill occur unless shown in an approved lot grading plan.

These plans are not reviewed for zoning conditions. contractor shall be responsible for all conditions noted.

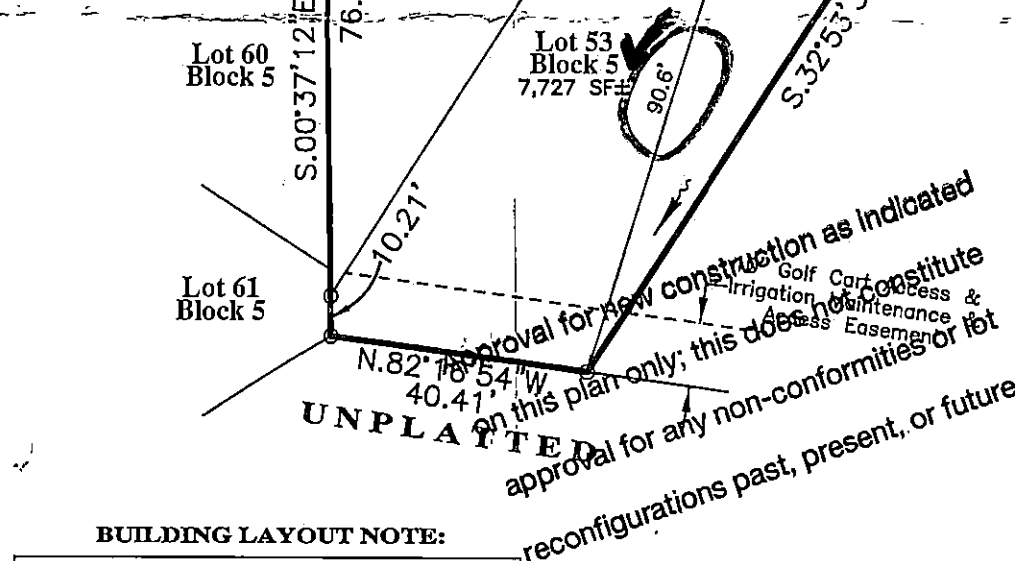

AREA (For Quantity Takeoff): Lot 53 Block 5

| | |
|-------------------------------------|------------|
| Brick Pavers (Driveway & Walk) | = 1004 SF± |
| Concrete Sidewalk (In Right Of Way) | = 76 SF± |
| Sod (Includes Lot To Back of Curb) | = 4804 SF± |

AREA (For Quantity Takeoff): Lot 54 Block 5

| | |
|-------------------------------------|------------|
| Brick Pavers (Driveway & Walk) | = 1178 SF± |
| Concrete Sidewalk (In Right Of Way) | = 175 SF± |
| Sod (Includes Lot To Back of Curb) | = 5926 SF± |

CURVE DATA TABLE

| NO. | RADIUS | DELTA | ARC | CHORD | BEARING |
|-----|---------|-----------|-------|-------|---------------|
| 152 | 187.50' | 17°06'56" | 56.01 | 55.80 | N.33°56'06"W. |
| 153 | 187.50 | 07°05'30" | 23.21 | 23.19 | N.21°49'53"W. |
| 154 | 70.00 | 11°47'22" | 14.40 | 14.38 | N.24°10'03"W. |

BUILDING LAYOUT NOTE:

Contractor and owner are to verify all setbacks, building dimensions, and layout shown hereon prior to any construction, and immediately advise GeoPoint Surveying, Inc. of any deviation from information shown hereon. Failure to do so will be at user's sole risk.

DIMENSION NOTE:

Proposed building dimensions shown hereon are of the exterior.

UNPLATED approval for any non-conformities or lot reconfigurations past, present, or future.

- LEGEND:**
- Pg. - Page
 - R/W - Right Of Way
 - O.R. - Official Records Book
 - P.B. - Plat Book
 - Elev. - Elevation
 - SF - Square Feet
 - Conc. - Concrete
 - BP - Brick Paver
 - SW - Sidewalk
 - CI - Curb Inlet
 - GTI - Grate Top Inlet
 - MES - Mitered End Section
 - RCP - Reinforced Conc. Pipe
 - PVC - Polyvinyl Chloride
 - P.K. - Parker Kalon Nail
 - SIR - Set 5/8" Iron Rod LB7768
 - SPKD - Set P.K. & Disk LB7768
 - FIR - Found 5/8" Iron Rod LB148 (Unless Noted Otherwise)
 - FIP - Found 1/2" Iron Pipe LB148 (Unless Noted Otherwise)
 - FPK - Found P.K. Nail
 - FPKD - Found P.K. Nail & Disk
 - FCM - Found Concrete Monument
 - REF - Reference
 - PRM - Permanent REF. Monument
 - PCP - Permanent Control Point
 - P.D.U.E. - Private Drainage Utility Easement (Note: Some items in above legend may not be applicable)

- L.B. - Licensed Business
- ST - Stoop
- WM - Water Meter
- WV - Water Valve
- FD - Fire Hydrant
- RWM - Reclaimed Water Meter
- RWV - Reclaimed Water Valve
- TE - Telephone Box
- EB - Electric Box
- CTB - Cable Television Box
- LP - Light Pole
- SSM - Storm Sewer Manhole
- SSSM - Sanitary Sewer Manhole
- EH/HO - Electric Handhole
- COO - Clean Out
- ICV - Irrigation Control Valve
- Sign
- AC - Air Conditioner
- P.U.E. - Public Utility Easement
- P.D.E. - Private Drainage Easement
- D.E. - Drainage Easement
- L.M.E. - Lake Maintenance Easement
- YD - Yard Drain
- A.E. - Access Easement
- L.B.E. - Landscape Buffer Easement
- R.W.E. - Raw Water Well Easement
- OWS - Water Service
- DFD - Drainage Flow Direction
- 10.0 - Proposed Design Grade
- 10.2 - As-Built/Existing Grade

SURVEYOR'S NOTES:

- Current title information on the subject property had not been furnished to GeoPoint Surveying, Inc. at the time of this plot plan.
- Roads, walks, and other similar items shown hereon were taken from engineering plans and are subject to survey.
- Elevations shown hereon are in feet and are referenced to the National Geodetic Vertical Datum of 1929 (NGVD29).
- Proposed grades & finished floor elevations shown hereon are from the SUN CITY CENTER UNIT 274 - 275 Grading & Drainage Plan, provided by HEIDT DESIGN.
- This Plot Plan is subject to matters shown on the Plat of SUN CITY CENTER UNIT 274 - 275.
- Air Conditioning Unit is 2'x4', offset from building 0.5' and meets the Hillsborough County Easement Encroachment Requirement.

PREPARED FOR:

MINTO COMMUNITIES, LLC

FLOOD ZONE:

The property shown hereon is on the Federal Emergency Management Agency's Flood Insurance Rate Map Panel Number 12057C0678H dated 08/28/08, and appears to lie in Zone "X".


DESCRIPTION: Lots 53 & 54, Block 5, SUN CITY CENTER UNIT 274 - 275, as recorded in Plat Book 123, Pages 82 through 93 inclusive, in the Public Records of Hillsborough County, Florida.

1403 E. 5th Avenue
Tampa, Florida 33605
Phone: (813) 248-8888
Fax: (813) 248-2266
Licensed Business No. LB7768



GeoPoint
Surveying, Inc.

| | | | |
|-----------------------------------|------------------------|--------------|--------------|
| Drawn: DJW | Checked: EVH | P.C.: ~ | Data File: ~ |
| Date: 06/13/16 | Dwg: 53&54_Blk5_PP.dwg | Order No.: ~ | |
| SEC. 18 - TWN. 32 S. - RNG. 20 E. | | Field Bk: ~ | |

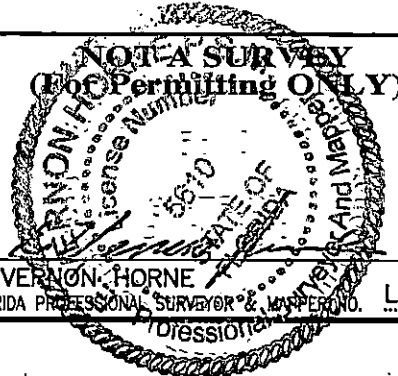

E. VERNON HORNE
FLORIDA PROFESSIONAL SURVEYOR & MAPPER NO. LS5610