
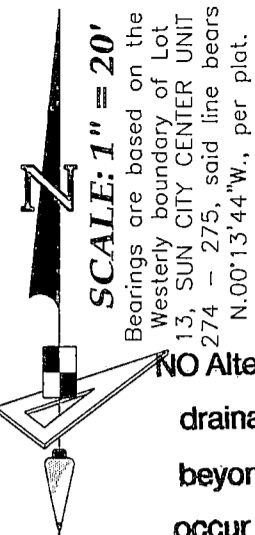


Plot Plan

This Plot Plan is based on a plat that has not been either approved nor submitted to Hillsborough County, Florida and is subject to change

These plans are not reviewed for zoning conditions, contractor shall be responsible for all conditions noted

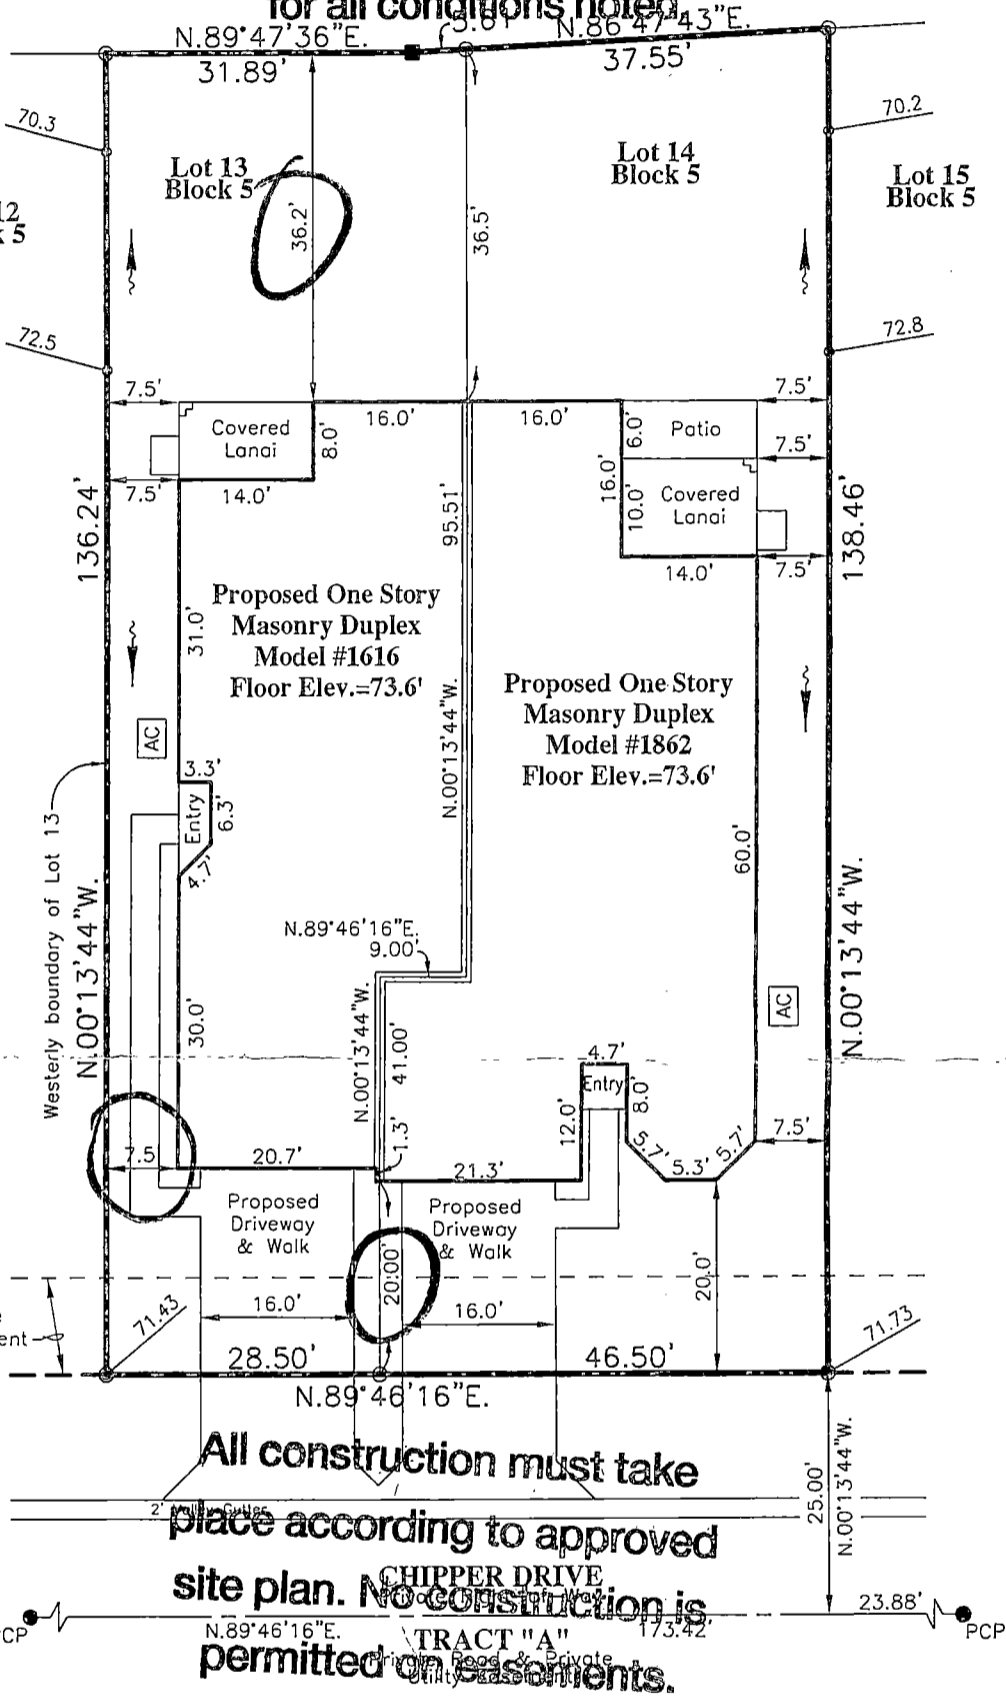

NO Alteration to the existing grading and drainage pattern and no additional fill beyond the limits of construction may occur unless shown in an approved lot

GENERAL NOTES:

Residence Footprint = 4,338 Square Feet
As per the plans furnished by the builder.
Combined Lot Area = 10,256± Square Feet
Combined Sod Area = 4,534± Square Feet

Setbacks: (Reported)

- 20ft. from all edge of pavement
- 15ft. minimum distance between buildings
- 20ft. from front of unit to all boundaries
- 15ft. from rear of unit to all boundaries
- 7.5ft. from side of unit to all boundaries
- Max Building Height = 35'

DIMENSION NOTE:

Proposed building dimensions shown hereon are of the exterior.

SUN CITY CENTER UNIT 274 - 275
PLAT BOOK 123, PAGES 82-93

Inside 140WB Gate 11-26-14

Approval for new construction as indicated

On this plan only; this does not constitute

Approval for any non-conformities or lot

Reconfigurations, past, present, or future

Contractor and owner are to verify all setbacks, building dimensions, and layout shown hereon prior to any construction, and immediately advise GeoPoint Surveying, Inc. of any deviation from information shown hereon. Failure to do so will be at user's sole risk.

SURVEYOR'S NOTES:

- Current title information on the subject property had not been furnished to GeoPoint Surveying, Inc. at the time of this plot plan.
- Roads, walks, and other similar items shown hereon were taken from engineering plans and are subject to survey.
- Elevations shown hereon are in feet and are referenced to the North American Vertical Datum of 1988 (NAVD88), to convert from NAVD88 to the National Geodetic Vertical Datum of 1929 (NGVD29) add 0.92' to the elevation.
- Proposed grades & finished floor elevations shown hereon are from the SUN CITY CENTER UNIT 274 - 275 Grading & Drainage Plan, provided by HEIDT DESIGN.
- This Plot Plan is subject to matters shown on the Plat of SUN CITY CENTER UNIT 274 - 275.

PREPARED FOR:

MINTO COMMUNITIES, LLC

FLOOD ZONE:

The property shown hereon is on the Federal Emergency Management Agency's Flood Insurance Rate Map Panel Number 12057C0678H dated 08/28/08, and appears to lie in Zone "X".

DESCRIPTION: VERAVA
Lots 13 and 14, Block 5, SUN CITY CENTER UNIT 274 - 275, as recorded in Plat Book 123, Pages 82 through 93 inclusive, in the Public Records of Hillsborough County, Florida.

1403 E. 5th Avenue
Tampa, Florida 33605
Phone: (813) 248-8888
Fax: (813) 248-2266
Licensed Business No. LB7768

GeoPoint
Surveying, Inc.

Drawn: SF Checked: WEL P.C.: ~ Data File: ~
Date: 11/13/14 Dwg: 13-14_PP.dwg Order No.: MIN-SC-078
SEC. 18 - TWN. 32 S. - RNG. 20 E. Field Bk: ~

NOT A SURVEY (For Permitting ONLY)

WILBANK E. LUCAS
FLORIDA PROFESSIONAL SURVEYOR & MAPPER NO. LS5782
NOT VALID WITHOUT THE SIGNATURE AND THE ORIGINAL RAISED SEAL OF A FLORIDA LICENSED SURVEYOR AND MAPPER

LEGEND:

Pg. - Page	L.B. - Licensed Business
R/W - Right Of Way	BFP - Backflow Preventer
O.R. - Official Records Book	W - Water Meter
P.B. - Plat Book	WV - Water Valve
Elev. - Elevation	FH - Fire Hydrant
SF - Square Feet	RCW - Reclaimed Water Meter
Conc. - Concrete	RCV - Reclaimed Water Valve
BP - Brick Pover	T - Telephone Box
SW - Sidewalk	E - Electric Box
CI - Curb Inlet	CTB - Cable Television Box
GTI - Grate Tap Inlet	L - Light Pole
MES - Mitered End Section	SSM - Storm Sewer Manhole
RCP - Reinforced Conc. Pipe	SSM - Sanitary Sewer Manhole
PVC - Polyvinyl Chloride	EHH - Electric Handhole
P.K. - Parker Kalon Nail	CO - Clean Out
SIR - Set 5/8" Iron Rod LB7768	ICV - Irrigation Control Valve
SPKD - Set P.K. & Disk LB7768	b - Sign
FIR - Found 5/8" Iron Rod	A/C - Air Conditioner
LB148 (Unless Noted Otherwise)	P.U.E. - Public Utility Easement
FIP - Found 1/2" Iron Pipe	C.U.E. - County Utility Easement
LB148 (Unless Noted Otherwise)	D.E. - Drainage Easement
FPK - Found P.K. Nail	L.M.E. - Lake Maintenance Easement
FPKD - Found P.K. Nail & Disk	C.E. - Conservation Easement
FCM - Found Concrete Monument	A.E. - Access Easement
REF - Reference	L.B.E. - Landscape Buffer Easement
PRM - Permanent REF. Monument	R.W.E. - Raw Water Well Easement
PCP - Permanent Control Point	OWS - Water Service
P.D.U.E. - Private Drainage Utility Easement	W - Drainage Flow Direction
(Note: Some items in above legend may not be applicable)	10.0 - Proposed Design Grade
	10.2 - As-Built/Existing Grade

REVISIONS

Description	Date	Dwn.	Ck'd	P.C.	Order No.	Field Book