

# Plot Plan

## GENERAL NOTES:

Residence Footprint = 4,226 Square Feet  
As per the plans furnished by the builder.

### Setbacks: (Reported)

- 20ft. from all edge of pavement
- 15ft. minimum distance between buildings
- 20ft. from front of unit to all boundaries
- 15ft. from rear of unit to all boundaries
- 7.5ft. from side of unit to all boundaries


Max Building Height = 35'

### BUILDING LAYOUT NOTE:


Contractor and owner are to verify all setbacks, building dimensions, and layout shown hereon prior to any construction, and immediately advise GeoPoint Surveying, Inc. of any deviation from information shown hereon. Failure to do so will be at user's sole risk.

NO Alteration to the existing grading and drainage pattern and no additional fill beyond the limits of construction may occur unless shown in an approved lot grading plan.

Bearings are based on the Northerly boundary of Lot 14, Block 4, SUN CITY CENTER UNIT 274 - 275, said line bears N.57°06'30"W., per plat.

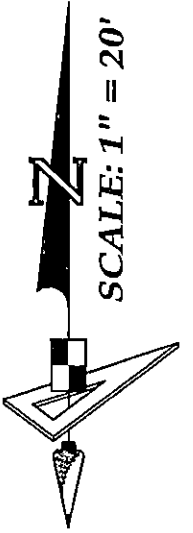

**SUN CITY CENTER UNIT 274 - 275**  
PLAT BOOK 123, PAGES 82-93

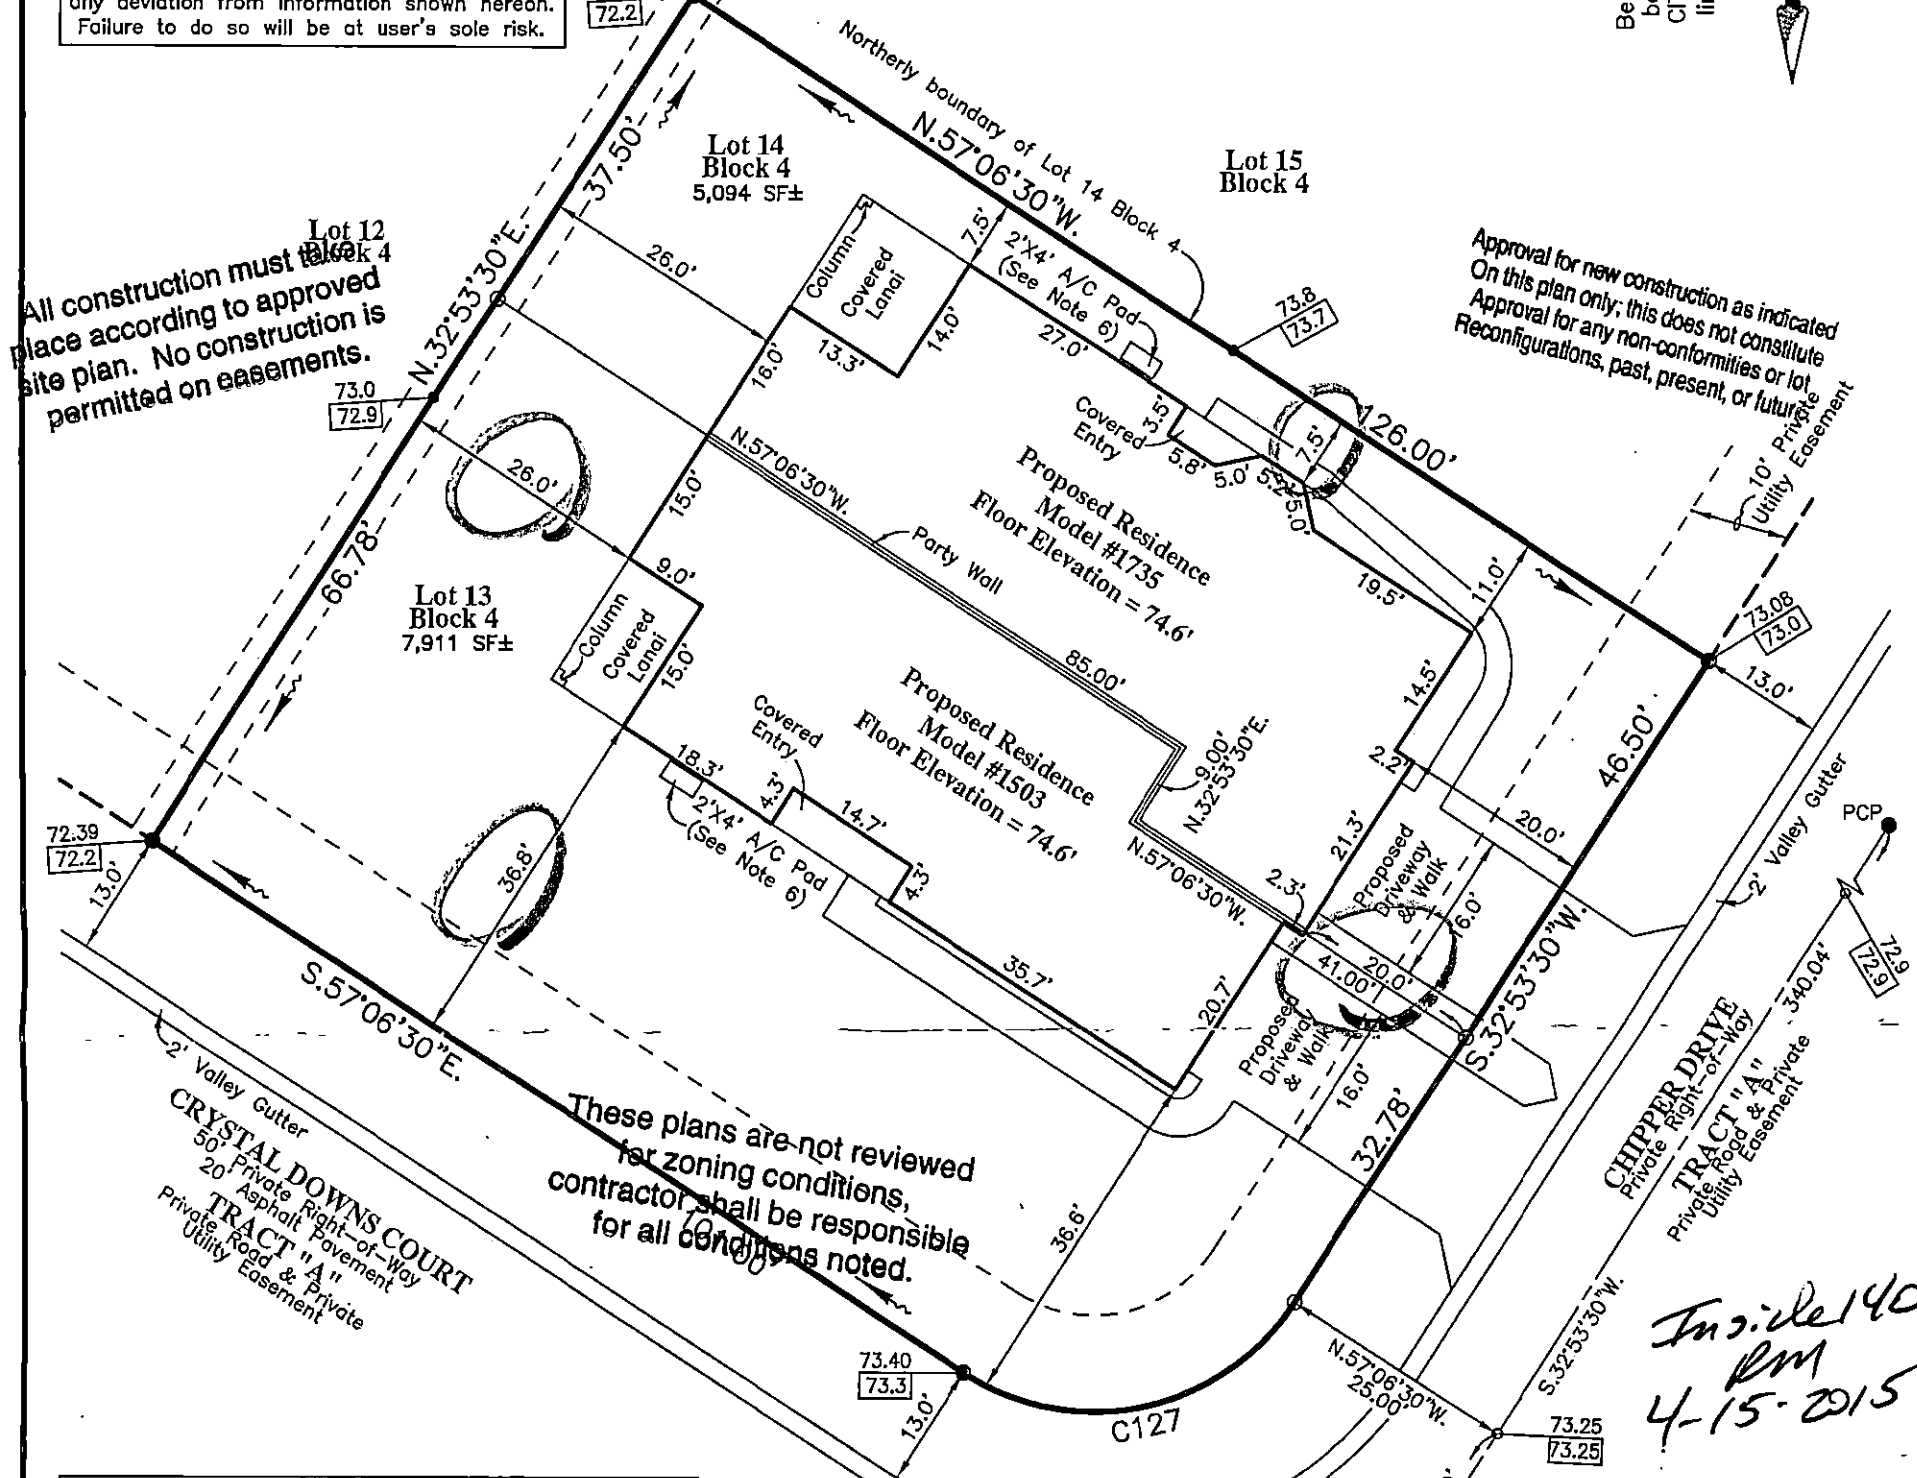

Approval for new construction as indicated on this plan only; this does not constitute approval for any non-conformities or lot reconfigurations, past, present, or future.

All construction must be placed according to approved site plan. No construction is permitted on easements.

Mechanical equipment may not project 3 feet or no more than 50% required side yard dimension shown hereon are of the exterior.

Inside 140  
RM  
4-15-2015

### SOD AND CONCRETE CALCS

Combined Total Lot Area in Square Feet ±	Total Sod Area in Square Feet ± (Includes right-of-way area between front property lines and back of curb)	Total Conc. Area in Square Feet ± (Includes Sidewalks and Driveway ONLY)
13,005	10,390	1,356

SEE DRAINAGE PLAN FOR GRADING AND ELEVATIONS

### CURVE DATA TABLE

NO.	RADIUS	DELTA	ARC	CHORD	BEARING
127	25.00	90°00'00"	39.27	35.36	N.77°53'30"E.

LEGEND:	
Pg.—Page	L.B.—Licensed Business
R/W—Right Of Way	ST—Stoop
O.R.—Official Records Book	W—Water Meter
P.B.—Plat Book	WV—Water Valve
Elev.—Elevation	FD—Fire Hydrant
SF—Square Feet	RCM—Reclaimed Water Meter
Conc.—Concrete	RCV—Reclaimed Water Valve
BP—Brick Paver	TE—Telephone Box
SW—Sidewalk	EB—Electric Box
CI—Curb Inlet	CTB—Cable Television Box
GTI—Grate Top Inlet	LP—Light Pole
MES—Mitered End Section	SM—Storm Sewer Manhole
RCP—Reinforced Conc. Pipe	SSM—Sanitary Sewer Manhole
PVC—Polyvinyl Chloride	EHH—Electric Handhole
P.K.—Parker Kalon Nail	COO—Clean Out
SIR—Set 5/8" Iron Rod LB7768	ICV—Irrigation Control Valve
SPKD—Set P.K. & Disk LB7768	—Sign
FIR—Found 5/8" Iron Rod	A/C—Air Conditioner
LB148 (Unless Noted Otherwise)	P.U.E.—Public Utility Easement
FIP—Found 1/2" Iron Pipe	C.U.E.—County Utility Easement
LB148 (Unless Noted Otherwise)	D.E.—Drainage Easement
FPK—Found P.K. Nail	L.M.E.—Lake Maintenance Easement
FPKD—Found P.K. Nail & Disk	C.E.—Conservation Easement
FCM—Found Concrete Monument	A.E.—Access Easement
REF—Reference	L.B.E.—Landscape Buffer Easement
PRM—Permanent REF. Monument	R.W.E.—Raw Water Well Easement
PCP—Permanent Control Point	OWS—Water Service
P.D.U.E.—Private Drainage Utility Easement	DFD—Drainage Flow Direction
(Note: Some items in above legend may not be applicable)	10.0—Proposed Design Grade
	10.2—As-Built/Existing Grade

### SURVEYOR'S NOTES:

- Current title information on the subject property had not been furnished to GeoPoint Surveying, Inc. at the time of this plot plan.
- Roads, walks, and other similar items shown hereon were taken from engineering plans and are subject to survey.
- Elevations shown hereon are in feet and are referenced to the National Geodetic Vertical Datum of 1929 (NGVD29).
- Proposed grades & finished floor elevations shown hereon are from the SUN CITY CENTER UNIT 274 - 275 Grading & Drainage Plan, provided by HEIDT DESIGN.
- This Plot Plan is subject to matters shown on the Plat of SUN CITY CENTER UNIT 274 - 275.
- Air Conditioning Unit is 2'x4', offset from building 0.5' and meets the Hillsborough County Easement Encroachment Requirement.

### PREPARED FOR:

MINTO COMMUNITIES, LLC

### FLOOD ZONE:

The property shown hereon is on the Federal Emergency Management Agency's Flood Insurance Rate Map Panel Number 12057C0678H dated 08/28/08, and appears to lie in Zone "X".

**DESCRIPTION:** Lots 13 and 14, Block 4, SUN CITY CENTER UNIT 274 - 275, as recorded in Plat Book 123, Pages 82 through 93 inclusive, in the Public Records of Hillsborough County, Florida.

1403 E. 5th Avenue  
Tampa, Florida 33605  
Phone: (813) 248-8888  
Fax: (813) 248-2266  
Licensed Business No. LB7768



**GeoPoint**  
Surveying, Inc.

Drawn: DJW	Checked: WEL	P.C.: ~	Data File: ~
Date: 03/04/15	Dwg: 13&14-Blk4-PP.dwg	Order No.: MIN-SC-088	Field Bk: ~
SEC. 18 - TWN. 32 S. - RNG. 20 E.		Field Bk: ~	

NOT A SURVEY  
(For Permitting ONLY)

WILLIAM E. OLIVAS  
FLORIDA PROFESSIONAL SURVEYOR & MAPPER NO. LS5782

NOT VALID WITHOUT THE SIGNATURE AND THE ORIGINAL RAISED SEAL OF A FLORIDA LICENSED SURVEYOR AND MAPPER

REGISTERED SURVEYOR